


GOVERNORS PLACE

33 BLOOMFIELD HILLS PARKWAY

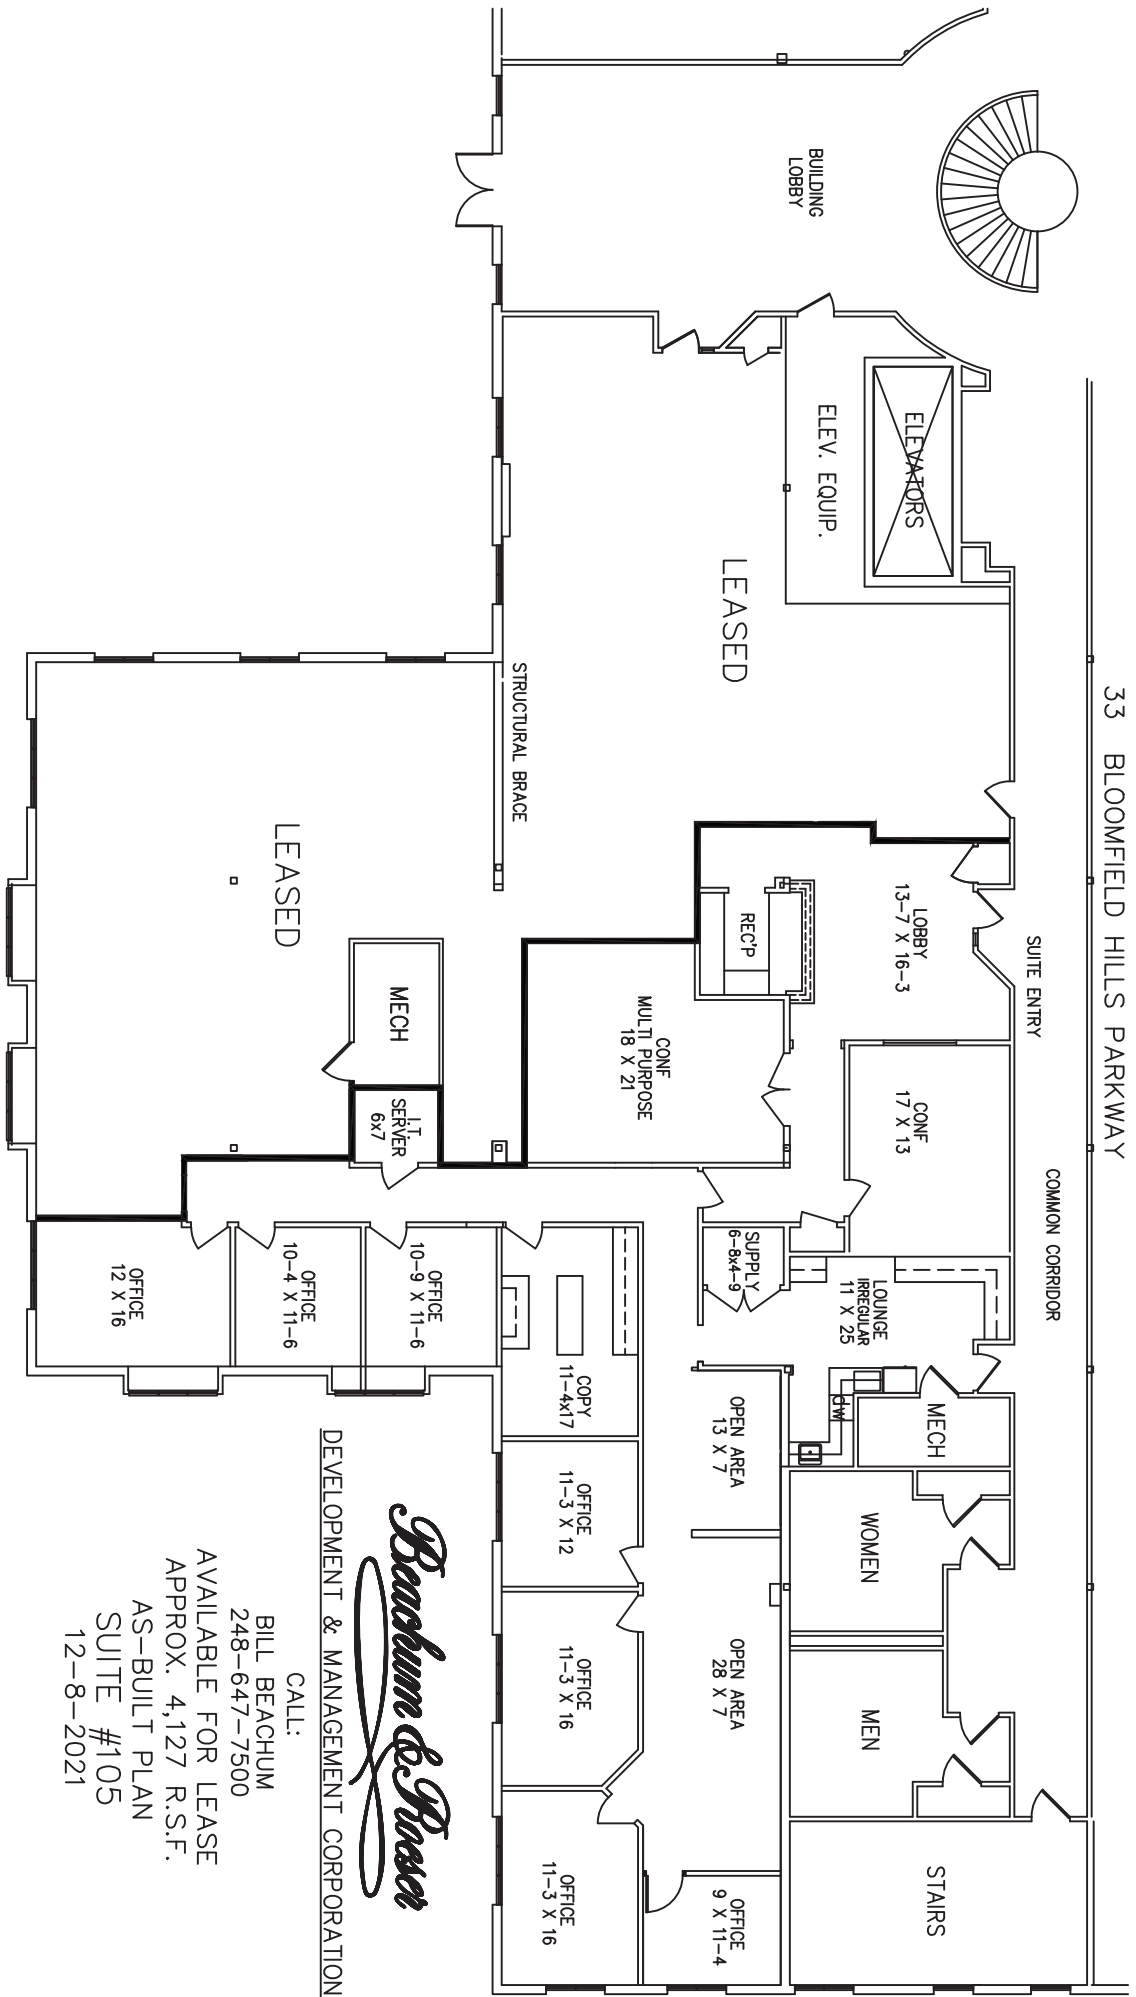

Beachum & Prosser
 DEVELOPMENT & MANAGEMENT CORPORATION

CALL: BILL BEACHUM
 248-647-7500
 AVAILABLE FOR LEASE
 APPROX. 4,127 R.S.F.
 AS-BUILT PLAN
 SUITE #105
 12-8-2021